

1-6

A 362859

Certified, Filed and or Recorded on
JAN. 06, 2009 AT 02:55PM


Signed: CK
MARILYN J NOVAK G V J
BENTON COUNTY MINNESOTA
MARILYN J NOVAK
COUNTY RECORDER

CERTIFICATE OF LOCATION OF GOVERNMENT CORNER

Northeast Corner of Section 12, Township 38 N, Range 29 W
4TH Principal Meridian, State of Minnesota, County of Benton

At the corner location shown on the sketch:

- On 4-26-2007 found a 1/2 inch iron pipe 0.5' below road surface.
DATE
- left monument as found lowered monument removed monument (explain)
- On _____ placed a _____
DATE

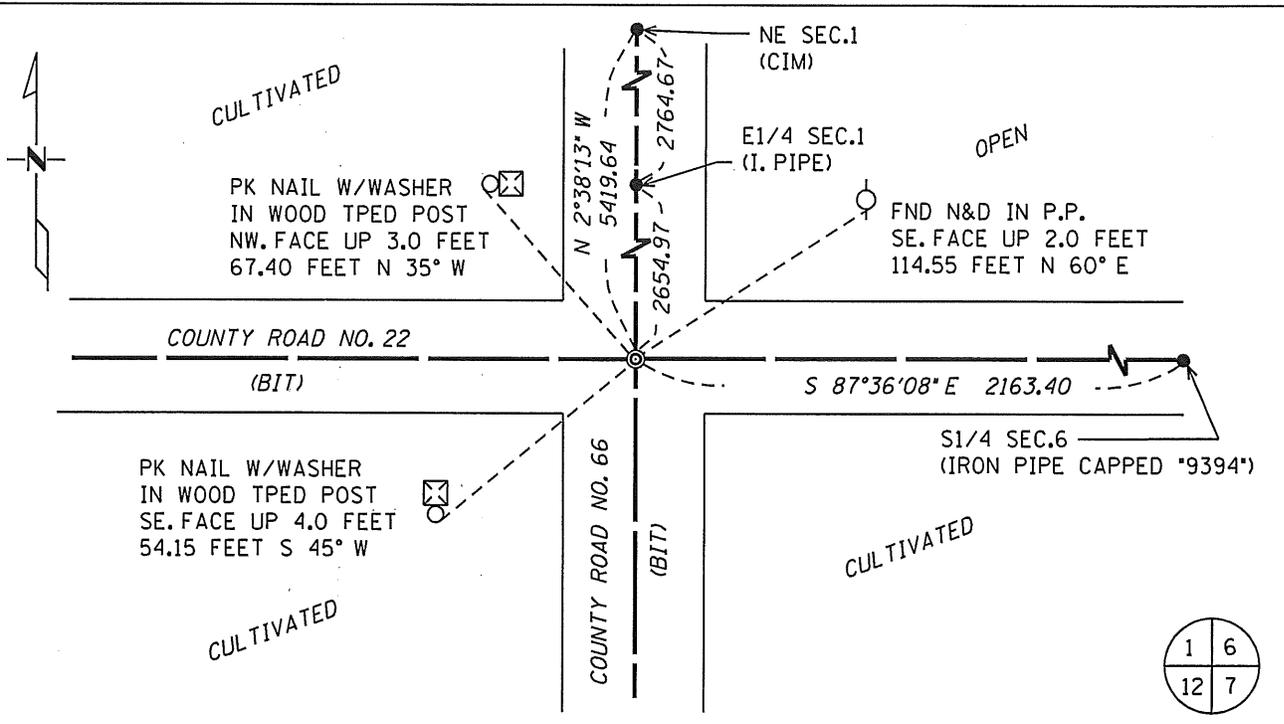

Statement of evidence for this corner location is on back of this page.

I hereby certify that this document was researched and prepared by me or under my direct supervision.

Signature Sam J. Deke Date 9-2-2008 License No. 40341

Title: Land Surveyor Professional Engineer County Surveyor County Engineer

Statement of Evidence:**B122**

Northeast Corner of Section 12, Township 38 North, Range 29 West, Alberta Township, 4th Principal Meridian, Benton County, Minnesota.

1849 Original US General Land Office survey established corner marked with a wood post and bearing trees noted as:

8" Sugar	N 11 W	50 links
10" Sugar	N 75 E	27 links
12" Sugar	S 48 E	31 links
14" Poplar	S 38 W	33 links

1936 County Engineer's Notebook No. 101 shows survey for road running south to north. Notes show corner in 4-way road intersection. Ties:

TP	SW	30.9
FP	NW	34.95

Stationing gives distances of 2650.2 feet to the East $\frac{1}{4}$ corner Sec. 12 and 5422.9 feet to the NE corner Sec. 1 with a delta angle of 2-28' left.

1939 County Engineer's Notebook No. 128 contains survey of CAR 22 running east to west on section line. Corner is shown as a spike set in center of road in line with fences north and south. Ties:

Mailbox Post	NW	35.4
FP	NE	63.3

1963 County Engineer's Notebook No. 249 contains survey of CAR 22 running west to east on section line. Corner is shown as a spike set in center of road with CH 66 running north-south. Ties:

TP	SW	49.25
3 rd FP (N)	NE	71.2
3 rd FP (E)	NE	77.65

(Notation of 1967 ties to iron pipe.)

1967 County Surveyor's Record Book 2, page 260, notes the following ties to an iron:

TP	SW	54.5
PP	NE	114.7
2 nd FP	NE	70.8

(Also gives date of 1938)

1967 County Engineer's Notebook No. 2, page 24, contains survey by Adelman of tract in SW $\frac{1}{4}$ of the SW $\frac{1}{4}$, Sec. 6. Notes state "located original wood stake and drive 1" iron pipe in at this point". Ties:

PP	NE	54.5
Fen. Cor	SW	66.3

(Also noted in County Surveyor's Record Book 2, page 238)

Northeast Corner of Section 12, Township 38 North, Range 29 West, Continued ...

2007 Sam DeLeo, LS 40341 found a ½" diameter iron pipe at the intersection of the centerlines of Co Rd 66 (N-S) and Co Rd 22 (E-W). The pipe measured 5419.64 feet southerly of a found concrete monument at the northwest corner of Section 6. The pipe was removed and the site was excavated by hand to a depth of 4 feet. No other monuments were found in the excavation. A nail and washer were found in a power pole 114 feet northeast of the pipe, which matches with the 1967 tie. No other previously recorded reference ties were found to be remaining. No monuments for the above mentioned Adelman tract that was surveyed in 1967 were found. The pipe measured 2163.40 feet west of a pipe found at the south quarter corner Section 6, Twp. 38, Rng. 28. This corresponds well with the 1939 distance of 2164.0 feet and the 1963 distance of 2166.9 feet. The iron pipe was re-set, coordinate values were established, and reference ties were recorded.

Coordinates Obtained by GPS
NAD 83 (1996 Adjustment)
N- 190,882.456
E- 542,070.022