

Certified, Filed and or Recorded on
Nov. 06, 2008 AT 08:42AM

Signed: CK
MARILYN J NOVAK G V J
BENTON COUNTY MINNESOTA
MARILYN J NOVAK
COUNTY RECORDER

CERTIFICATE OF LOCATION OF GOVERNMENT CORNER


EAST QUARTER Corner of Section 36, Township 37N., Range 29W.
4TH Principal Meridian, State of Minnesota, County of Benton

At the corner location shown on the sketch:

On 10/21/2008 found a 3/8" IRON PIN 1.1± BELOW BIT. SURFACE.

left monument as found lowered monument removed monument (explain)

On _____ placed an _____

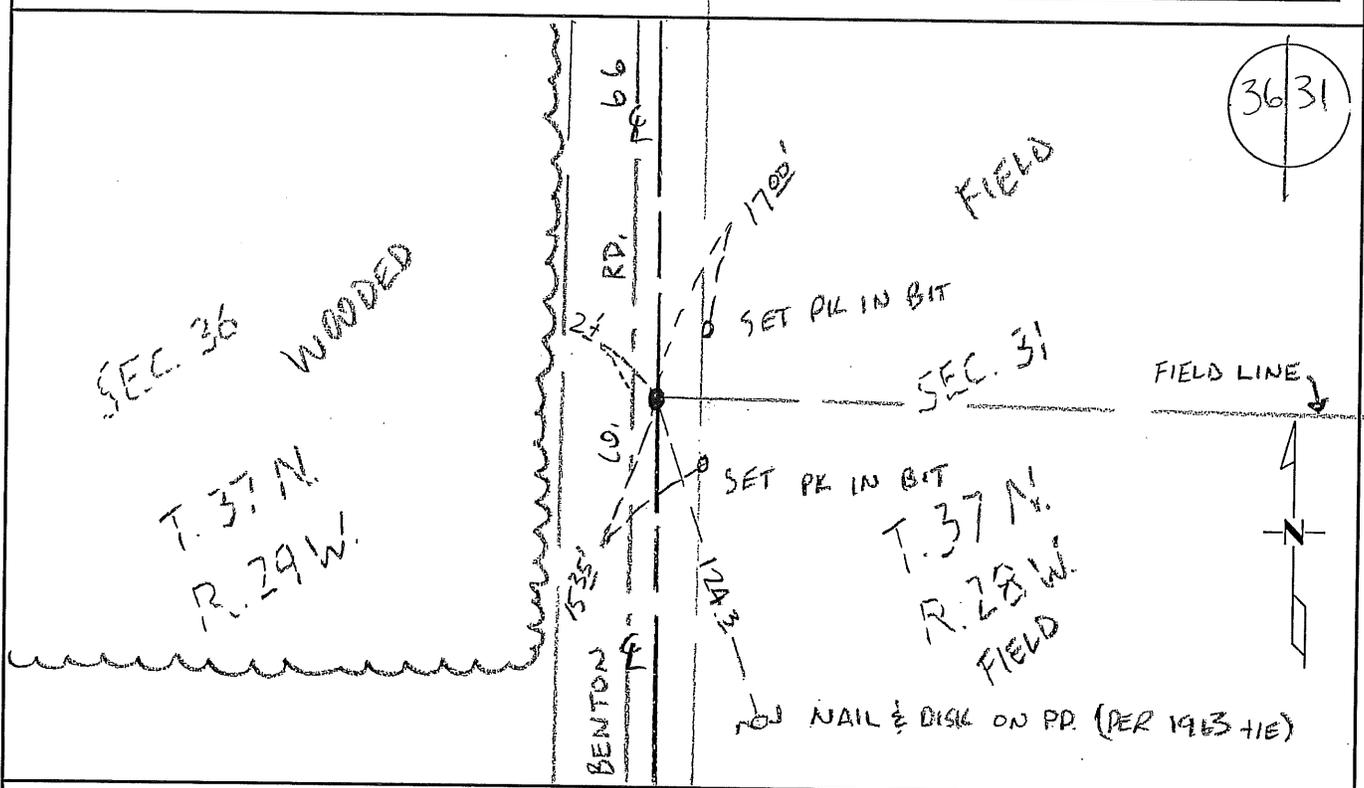

Statement of evidence for this corner location is on back of this page.

I hereby certify that this document was researched and prepared by me or under my direct supervision and that I am a licensed Land Surveyor under the laws of the State of Minnesota.

Signature Jan W. Ols
Deputy Benton County Surveyor
License No. 45872

Date: 11/04/2008

Benton County Surveyor's Office
 Jason W. Oberg, Deputy County Surveyor
 Minnesota License No. 45872

Statement of Evidence:**H363**

East Quarter Corner of Section 36, Township 37 North, Range 29 West, Gilmanton Township, 4th Principal Meridian, Benton County, Minnesota.

1849 Original US General Land Office survey set a wood post at this location and bearing trees were recorded.

8" W Oak	N 63 ½ W	114 links
10" Blk Oak	S 64 E	11 links

A line tree was noted as a 30" Elm North 18.29 chains.

1901 County Surveyor's Record Book A, Map No. 42 shows a survey by John Whilt of Section 31, 37-28. Survey shows a distance of 40.54 chains (2675.64 feet) to the NE corner Sec 36 and a distance of 40.31 ½ chains (2660.79 feet) to the SE corner Sec 36.

1939 County Engineer's Notebook No. 131 contains survey of CAR 32 running south to north on township line. Corner is shown as a hub placed in center of road with fence line west. Ties:

Cor. FP	W	22.0
FP	NW	26.5

Stationing gives distances of 2657.2 feet to the SE corner and 2679.5 feet to the NE corner.

1963 County Surveyor's Record Book 1, page 531, notes a found old wood post, which was replaced with an iron with the following reference ties:

PP	SE	124.0
10" Elm Stump	E	41.8
FP	SW	45.7

(County Engineer's Notebook No. 131 has same notation showing corner found and replaced with iron.)

2008 The County Surveyor's Office searched and found a 3/8" iron pin 1.1' below the bituminous surface on a north-south road (County Road No. 66). The pin falls 2 ft.± east of the travelled centerline and in line with a field line to the east. The power pole tie (Nail & Disk) in 1963 was found and measured 124.3 ft. Distances to the NE and SE Corners measure 2679.96 ft. and 2657.94 ft., respectively, which compare well with the above 1939 distances to same. The Surveyor accepts the iron pin and updated ties to same.

County Coordinates Obtained by GPS to iron pin
 NAD 83 (1996 Adjustment)
 N-135111.931
 E-542405.191