

Office of the County Recorder, BENTON County, Minnesota  
I hereby certify that the within instrument was filed for record in this office on the  
\_\_\_\_\_ day of \_\_\_\_\_, 200\_\_\_\_.

COUNTY RECORDER

By \_\_\_\_\_ Deputy.

### CERTIFICATE OF LOCATION OF GOVERNMENT CORNER


North Quarter \_\_\_\_\_ Corner of Section 22, Township 38, Range 30  
4TH Principal Meridian, State of Minnesota, County of BENTON

At the corner location shown on the sketch:

On 08/03/01 found a 1/2" Solid Pin  
DATE

left monument as found     lowered monument     removed monument (explain)

On 12/12/01 placed a Cast Iron Monument  
DATE

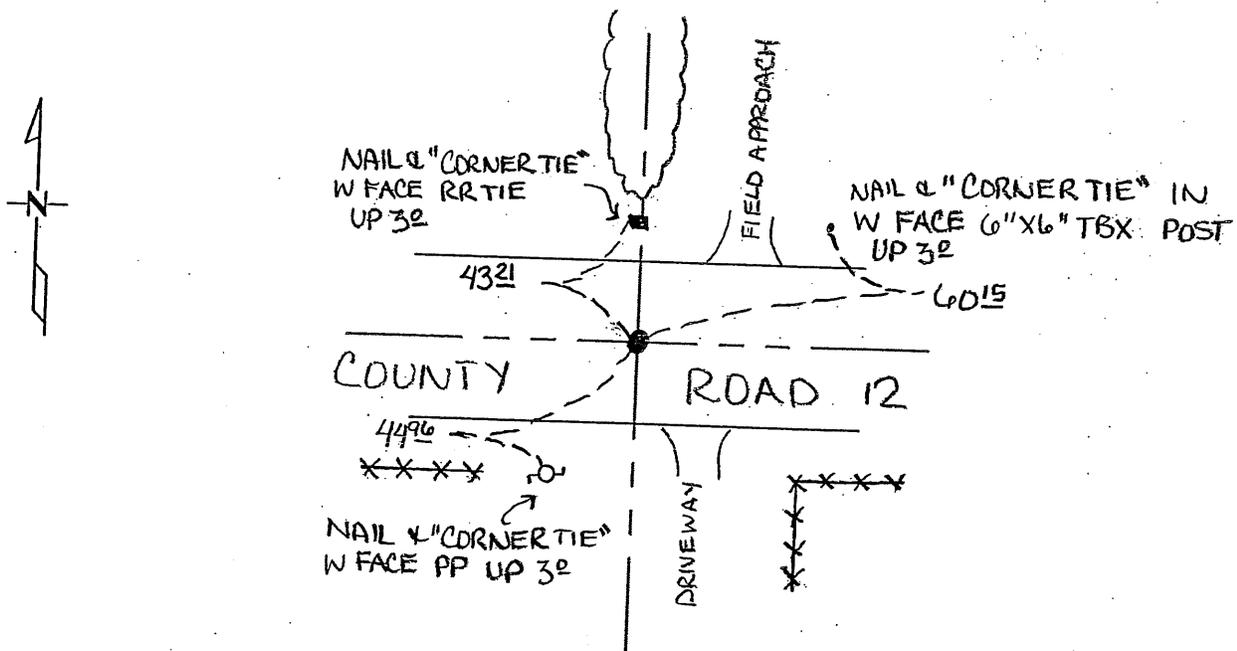

Ties that are found and in good condition are noted as 'existing'. New tree and power pole ties are to the head of a nail with a brass disk marked 'Corner Tie'.

Statement of evidence for this corner location is on back of this page.

I hereby certify that this document was researched and prepared by me or under my direct supervision and that I am a licensed Land Surveyor under the laws of the State of Minnesota.

Signature [Signature] Date 4/18/02 License No. 10461

Title:  Land Surveyor     Professional Engineer     County Surveyor     County Engineer

Statement of Evidence:

C221

The North Quarter Corner of Section 22, Township 38 North, Range 30 West, Graham Township, 4<sup>th</sup> Principal Meridian, Benton County, Minnesota.

In 1852, Edwin James Jr. set a wood post was set at this location and bearing trees were recorded.

7" Aspen	N 36 E	13 links
8" Aspen	S 9 W	25 links

In 1963, the County Surveyors records in Book 2, page 200 show an iron at this location with the following reference ties.

T.P.	NE	59.6
Cor. F.P.	N	42.7
P.P.	SW	45.6
F.P.	SE	57.8

On July 24, 2001 Westwood Professional Services, Inc. found a 1/2" iron pin down 1.2 feet at the intersection of the centerline of County Road 12 (running east and west) and a tree line (from the north) and a fence line (from the south). This appears to check with the ties from 1963.

On December 12, 2001 Westwood Professional Services, Inc. set a cast iron monument at the location of the 1/2" iron pin and established reference ties. We accepted the pin as marking the obliterated corner position.

Coordinates Obtained by GPS  
NAD 83 (1996 Adjustment)  
N-180406.324  
E-497358.347

MARILYN J. NOVAK  
COUNTY RECORDER  
BY Marilyn J. Novak DEPUTY

OFFICE OF  
BENTON COUNTY RECORDER  
BENTON COUNTY, MN  
CERTIFIED TO BE FILED  
AND/OR RECORDED ON

285642

2002 MAY -7 A 8:29