

1-6

A 362869

Certified, Filed and or Recorded on  
JAN. 06, 2009 AT 03:05PM


Signed: CK  
MARILYN J NOVAK 6 V J  
BENTON COUNTY MINNESOTA  
MARILYN J NOVAK  
COUNTY RECORDER

# CERTIFICATE OF LOCATION OF GOVERNMENT CORNER

North Quarter Corner of Section 29, Township 38 N, Range 30 W  
4TH Principal Meridian, State of Minnesota, County of Benton

At the corner location shown on the sketch:

- On 8-14-2008 found a Cast Iron Monument, down 0.3 feet.  
DATE
- left monument as found     lowered monument     removed monument (explain)
- On \_\_\_\_\_ placed a \_\_\_\_\_  
DATE

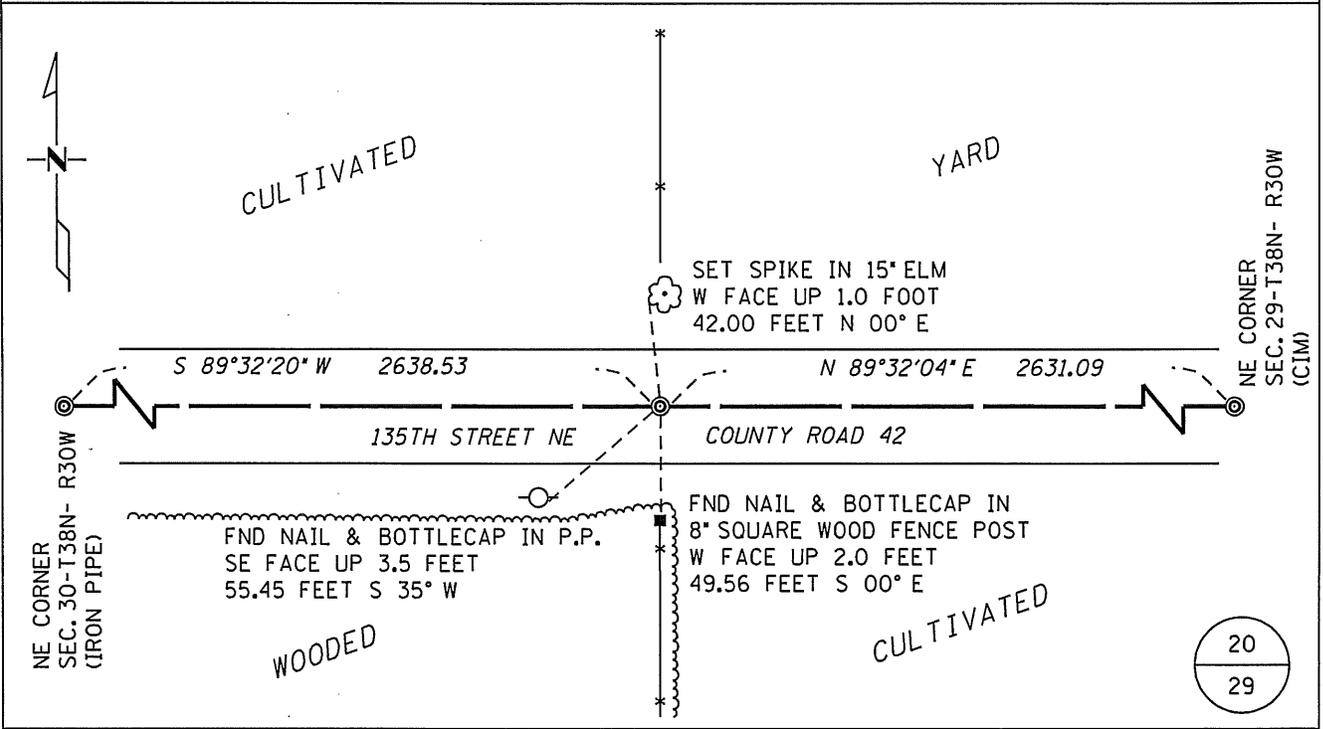

Statement of evidence for this corner location is on back of this page.

I hereby certify that this document was researched and prepared by me or under my direct supervision.

Signature Sam J. Debo Date 10-3-2008 License No. 40341  
Title:  Land Surveyor     Professional Engineer     County Surveyor     County Engineer

**Statement of Evidence:**

C291

North Quarter Corner of Section 29, Township 38 North, Range 30 West, Graham Township, 4<sup>th</sup> Principal Meridian, Benton County, Minnesota.

- 1852 Original US General Land Office survey set a wood post at this location and bearing trees were recorded.
- |             |           |           |
|-------------|-----------|-----------|
| 10" Blk Oak | N 39 E    | 117 links |
| 6" Blk Oak  | S 4 1/2 W | 76 links  |
- 1952 Roll F-02 of MN/DOT alignment map for TH 25 notes the corner is assumed to be at the intersection of the centerlines of an east/west road and a north/south fence line. It also notes a distance of 2631.0 feet to the NE corner Sec 29 and a distance of 2649.1 feet to centerline.
- 1963 The Minnesota Dept. of Natural Resources (fka MN Conservation Dept.) performed a survey in Sections 29 and 30 for the Wisneski WMA (File No. G892-X). They surveyed the north line of Sec. 29, but make no reference to the NQ corner of Sec. 29. The distance between the NE corner of Sec. 30 (Spike set at assumed pos. of PI) and NE corner of Sec. 29 (Spike set at assumed pos. of PI) was recorded to be 5289 feet (dbl. chained).
- 1999 Information from Paul Wellen, LS 10461, shows CIM found.
- 2002 No resurvey information was found on this corner in the Benton County records.
- 2004 Certificate of Survey by Barry Dorniden, LS 23044, shows PK Nail set for the corner with a computed distance of 2631.09 feet to the NE corner.  
County Coordinates Computed from Dorniden survey.  
NAD 83 (1996 Adjustment)  
N- 175091.431  
E- 486850.992
- 2008 Sam DeLeo, LS 40341, found a CIM at the centerline of the E-W road and fences N & S. The measured distance of 2631.09 feet to the NE of Sec. 29 and established coordinate values to the CIM match well with Doriden's records. The measured distance of 5269.63 feet between section corners E & W does not match well with the 1963 distance. Reference tie markers consisting of nails and bottle caps were found in a fence post to the south and in a power pole to the SW. One new reference tie was set and ties to said accessories were recorded. Coordinate were established on the monument.
- County Coordinates (RTK'ed)  
NAD 83 (1996 Adjustment)  
N- 175091.324  
E- 486850.989