

A 361587

Certified, Filed and or Recorded on
Nov. 06, 2008 AT 08:44AM


Signed: CK
MARILYN J NOVAK G V I
BENTON COUNTY MINNESOTA
MARILYN J NOVAK
COUNTY RECORDER

CERTIFICATE OF LOCATION OF GOVERNMENT CORNER

EAST QUARTER Corner of Section 24, Township 37N, Range Z8W
4TH Principal Meridian, State of Minnesota, County of Benton

At the corner location shown on the sketch:

- On 10/23/08 found a ties to corner per Certificate of Location of record. (Mille Lacs Co. # 244628)
- left monument as found lowered monument removed monument (explain)
- On 10/28/08 placed an 1/2" IRON PIPE WITH CAP #19552 DOWN 0.4'
IN ACCORDANCE WITH TIES.

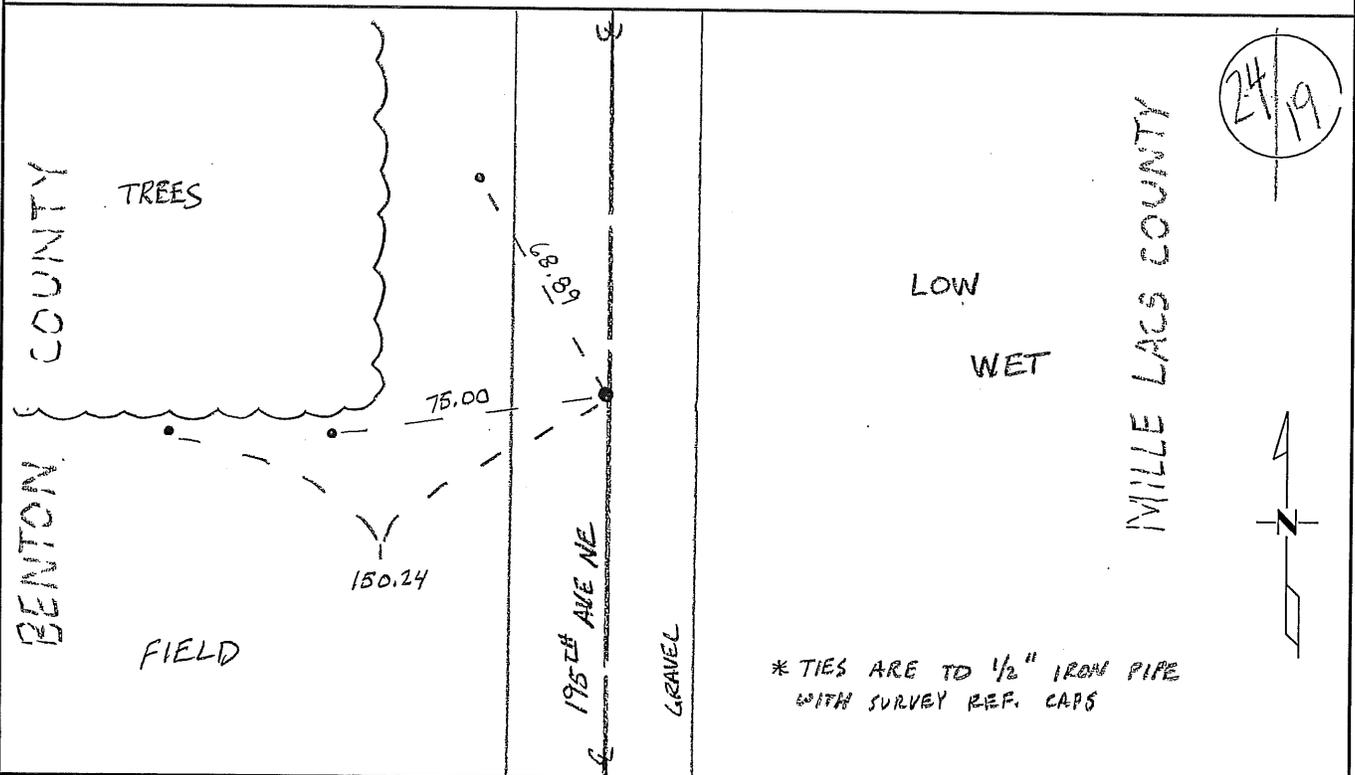

Statement of evidence for this corner location is on back of this page.

I hereby certify that this document was researched and prepared by me or under my direct supervision and that I am a licensed Land Surveyor under the laws of the State of Minnesota.

Signature Jan W. Olg
Deputy Benton County Surveyor
License No. 45872

Date: 11/04/2008

Benton County Surveyor's Office
 Jason W. Oberg, Deputy County Surveyor
 Minnesota License No. 45872

Statement of Evidence:

I243

East Quarter Corner of Section 24, Township 37 North, Range 28 West, Maywood Township, 4th Principal Meridian, Benton County, Minnesota.

1849 Original US General Land Office survey set a wood post at this location and bearing trees were recorded.

10" Tamarack S 6 ½ W 418 links

12" Tamarack N 51 W 190 links

Line trees were noted as a 4" Blk Ash South 21.10 chains and a 22" Pine North 22.12 chains.

1996 John Oliver, LS 8194, Mille Lacs County Surveyor, set corner by lost method (north-south) and held center of north-south road (east-west) and filed Certificate of Location (No. 244628)

2002 No resurvey information was found on this corner in the Benton County records.

2008 The County Surveyor's Office searched and found no monument but did find ties to the same as documented in Oliver's Certificate of Location (Mille Lacs County No. 244628). The Surveyor re-set the monument, which falls in line with a field line to the west and on centerline with a north-south road (195th Ave NE). Distances to the NE Cor. and SE Cor. measure 2634.98 ft. and 2635.06 ft., respectively, and the corner falls on a straight line between said corners, thus confirming Oliver's lost method. The Surveyor accepts Oliver's position and recorded ties.

Benton County Coordinates obtained by GPS
 NAD 83 (1996 Adjustment)
 N-146014.766
 E-573790.408

CERTIFICATE OF LOCATION OF GOVERNMENT CORNER

East Quarter Corner of Section 24, Township 37, Range 28, 4 P.M.

STATE OF MINNESOTA, County of BENTON


At the corner location shown on the sketch:

On _____ found a _____
DATE

left monument as found, lowered monument, removed monument (explain)

On 7/23/96 placed a 3/4" Iron Pipe (Down 0.2'±) On Centerline
DATE

SKETCH OF REFERENCE TIES

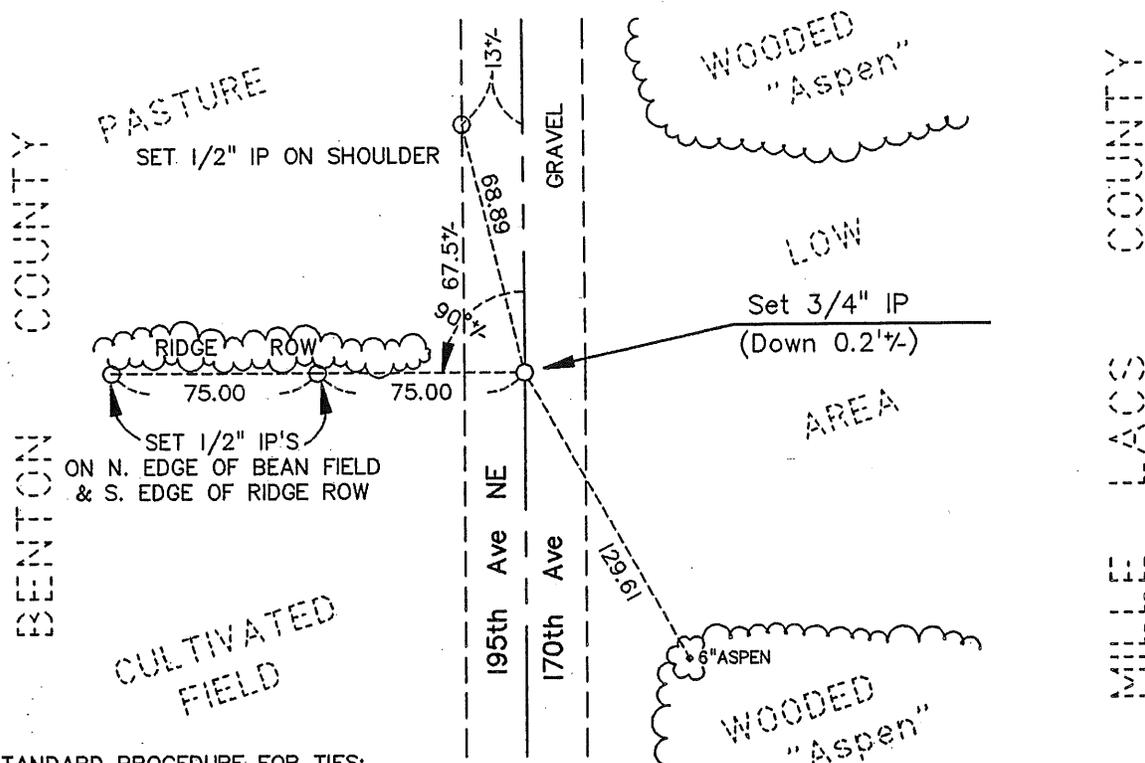

STANDARD PROCEDURE FOR TIES:

Tree ties are to the head of a pole barn nail w/red ribbon set at 1", 1/2", out from face of blaze.
Power poles, etc., are nail and washer in face.
Building ties are to corner of foundation unless otherwise noted.

24 | 19

Statement of evidence relative to this corner location is on back of this page.

142/59

I hereby certify that this document and the data contained herein was prepared by me or under my direct supervision.

John D. Oliver 9/4/96
SIGNATURE DATE

Registration No. 8194

- Land Surveyor Professional Engineer
 County Surveyor County Engineer

OFFICE OF THE REGISTER OF DEEDS
County of BENTON

I hereby certify that this document was filed in the Register of Deeds office at _____ M. on the _____ day of _____ A.D., 19 ____

Register of Deeds _____

By _____, Deputy

DOCUMENT NO. _____

STATEMENT OF EVIDENCE

STATEMENT OF EVIDENCE:

East Quarter Corner of Section 24, T. 37, R. 28, Benton Co., MN.

West Quarter Corner of Section 19, T. 37, R. 27, Mille Lacs Co., MN.

The line between Ranges 27 & 28, T. 37, was run by Dep. Surveyor Theo. Conkey in Oct. 1849. We were unable to find any remnants of his* monument or accessories for this corner.

*Please see the Certificate Of Location for the NE corner of Section 1, T. 37, R. 28, Benton County; also being the NW corner of Sec. 6, T. 37, R. 27, Mille Lacs County; for a "discussion" regarding general conditions (including GLO resurveys and "Judicial Roads") affecting the locations of the corners along this County line.

In 1994 we were hired by Benton Co. to restore certain corners along their east Co. line. Old survey notes, subsequent to the GLO notes, from both counties, if any, are as follows (in chronological order):

Benton: Requested from the Co. Hwy. Dept.. None provided other than GLO notes.

Mille Lacs: None along this line other than GLO.

We are aware of no other surveys by others other than: In 1994 Comstock & Davis, Inc., via their Little Falls office, was hired to provide Benton County with geodetic coordinates on selected corners within the County. They did this with a combination of GPS and traditional methods. The subject corner was not restored during said survey.

After thorough and careful analysis we restored this corner by SPM between the restored NW and SW corners of said Sec. 19, but off of the straight line and on the centerline of travel of the north-south road. Because there was no record of subsequent monuments we did not excavate.

On 7/23/96 we placed a 3/4" iron pipe as shown on the front hereof.

MLCLS: /WQ193727

BY *Alice O. Engelbayer* DEPUTY

ALICE O. ENGELBAYER
COUNTY RECORDER

OCT 3 8 49 AM '97

OFFICE OF
BENTON COUNTY RECORDER
BENTON COUNTY, MN
CERTIFIED TO BE FILED
AND/OR RECORDED ON

244628