

A 368331

Certified, Filed and or Recorded on
Aug. 24, 2009 AT 08:12AM


Signed: CK
MARILYN J NOVAK G V I
BENTON COUNTY MINNESOTA
MARILYN J NOVAK
COUNTY RECORDER

CERTIFICATE OF LOCATION OF GOVERNMENT CORNER

NORTH EAST Corner of Section 15, Township 36, Range 30
4TH Principal Meridian, State of Minnesota, County of Benton

At the corner location shown on the sketch:

- On 25 MAR 2008 found a 1/2-inch iron pipe at intersection
DATE of center lines
- left monument as found lowered monument removed monument (explain)
- On 25 MAR 08 placed an PK NAIL & WASHER OVER EXISTING
DATE MONUMENT

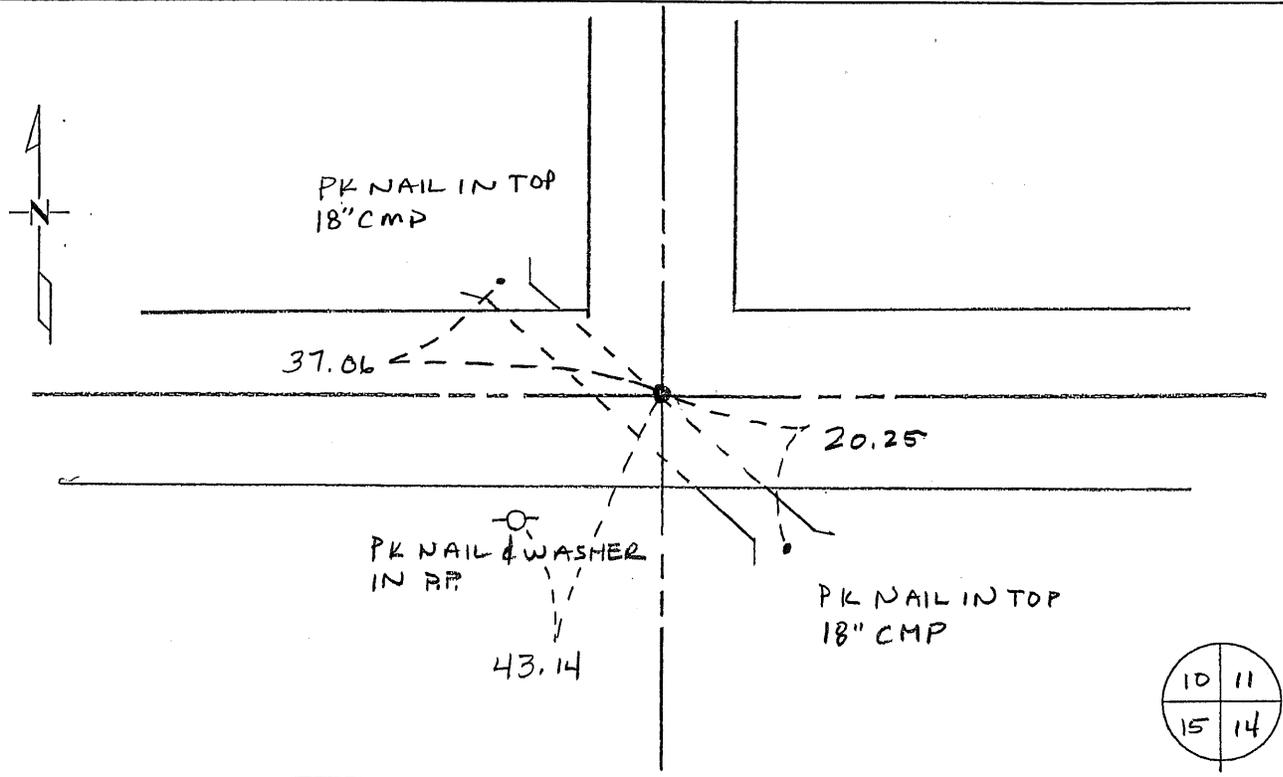

Statement of evidence for this corner location is on back of this page.

I hereby certify that this document was researched and prepared by me or under my direct supervision and that I am a licensed Land Surveyor under the laws of the State of Minnesota.

Signature Jerome C. Wittstock Date 20 August 2009 License No. 19552

Title: Land Surveyor Professional Engineer County Surveyor County Engineer

Benton County Surveyor's Office
 Jerome C. Wittstock, County Surveyor
 Minnesota License No. 19552

Statement of Evidence:**L152**

Northeast Corner of Section 15, Township 36 North, Range 30 West, Minden Township, 4th
 Principal Meridian, Benton County, Minnesota.

1852 Original US General Land Office survey established this corner and a wood post was set
 for the corner and bearing trees were recorded.

10" Bur Oak	S.59 1/4 W	185 links
8" Bur Oak	N 23 1/2 W	85 links

No Date Ties	3 rd Fence post	NE	46.6
	Corner FP	E	32.9

No Date County Surveyor's Record Book 1, page 189 gives ties to iron sleigh shoe:

TP	SE	35.9
S. end culvert	SW	22.6
N. end culvert	NW	26.5

1961 M.W. Carley ties call for iron sleigh shoe:

TP	NW	40.7
PP	SW	43.12

1971 William Lunser, LS 9394, filed a Certificate of Location showing corner marked by a
 found 3/4-inch iron pipe in centerline of roads north and west. Distances measured:
 2651.66 feet to north quarter corner of Section 15 and 2679.04 feet to the east quarter
 corner of Section 15. Tie to PP southwest fits MWC's.

1995 Comstock and Davis performed GPS work under contract with Benton County and
 Coordinates Obtained by GPS NAD 83 (1986 Adjustment) to a set 1/2 " iron pipe over a
 3/4-inch iron pipe:

N - 121332.552
 E - 500082.358

2002 Westwood Professional Services, Inc. found 1/2-inch iron pipe. No evidence found of
 GLO BTs or old ties.

County Coordinates obtained by GPS to iron pipe:


NAD 83 (1996 Adjustment)
 N- 121332.742
 E- 500081.895

2008 Westwood Professional Services, Inc. placed a PK nail and Benton County Washer flush
 with bituminous surface over found/existing 1/2" iron pipe. Distances agree with
 Lunser's 1971 distances. Reference ties were updated and coordinates verified.

CERTIFICATE OF LOCATION OF GOVERNMENT CORNER

I hereby certify that on the 1 day of March, 1971
I did find _____ the northeast corner of Section 15,
Twp. 36, Rg. 30, Benton County, Minnesota, which
was evidenced by a 3/4" iron pipe found in place

I further certify that in order to perpetuate said corner I did
at the exact location thereof place a permanent marker consisting
of _____ left as it was _____ and that
I did establish witness or reference monuments as shown below:

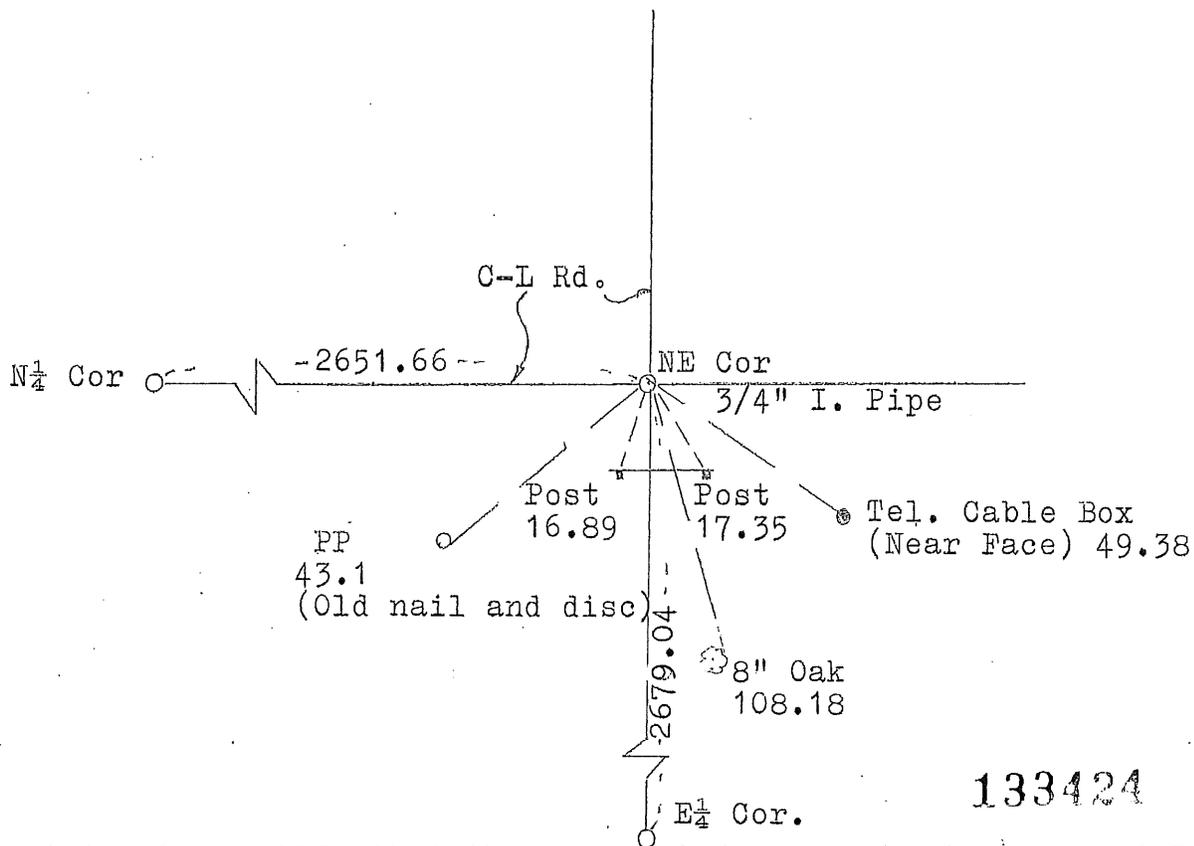

I hereby certify that the above is true and correct and that I am a registered Land Surveyor under the laws of the State of Minnesota.

Walter J. Johnson

Minn. Registration No. 9394

Office of the Register of Deeds,
Benton County, Minn.

I hereby certify that the within instrument was filed for record in this office on the 9th day of February, 1973.

J. A. Johnson
Register of Deeds

By Marilyn Novak Deputy.