

Certified, Filed and or Recorded on  
Mar. 10, 2009 AT 01:04PM


Signed: CK  
MARILYN J NOVAK G V I  
BENTON COUNTY MINNESOTA  
MARILYN J NOVAK  
COUNTY RECORDER

# CERTIFICATE OF LOCATION OF GOVERNMENT CORNER

EAST QUARTER Corner of Section 1, Township 36, Range 31  
4TH Principal Meridian, State of Minnesota, County of Benton

At the corner location shown on the sketch:

- On 11-24-08 found a CAST IRON MONUMENT
- left monument as found       lowered monument       removed monument (explain)
- On \_\_\_\_\_ placed an \_\_\_\_\_

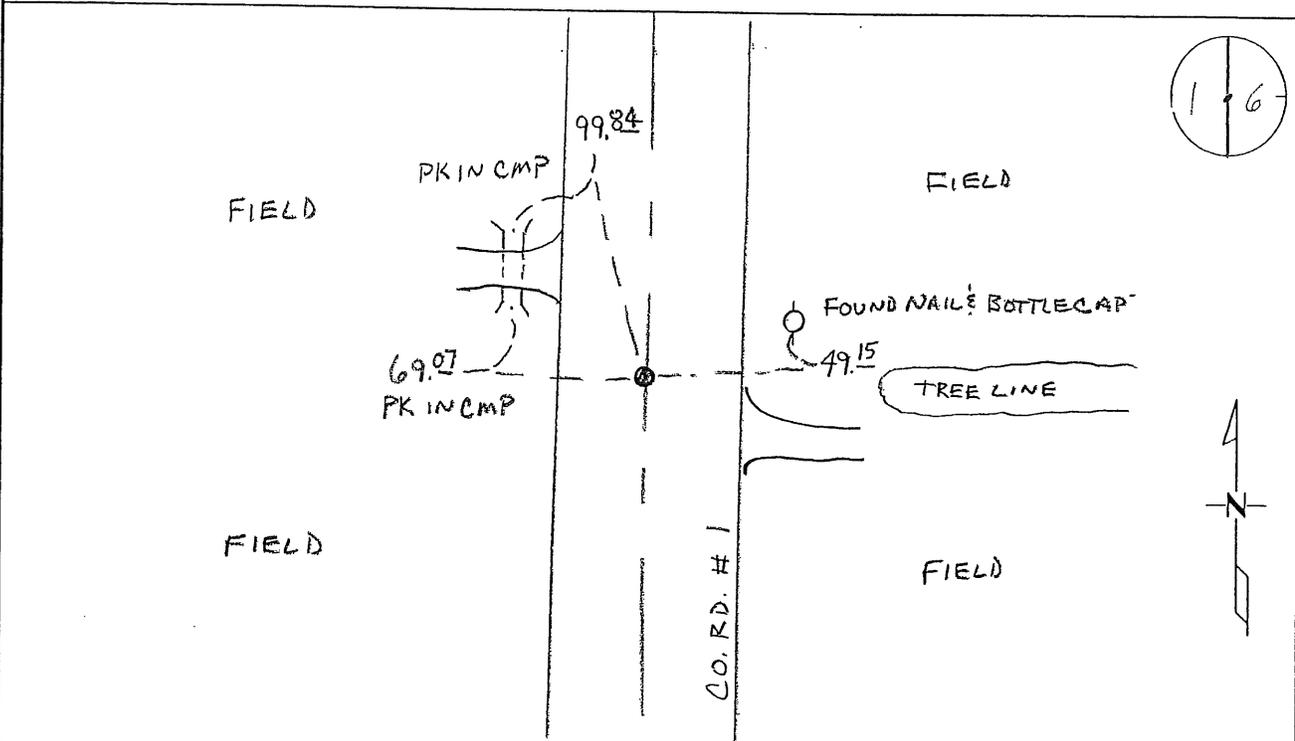

Statement of evidence for this corner location is on back of this page.

I hereby certify that this document was researched and prepared by me or under my direct supervision and that I am a licensed Land Surveyor under the laws of the State of Minnesota.

Signature Chris Hoyle  
Deputy County Surveyor  
License No. 43932

Date: 3/6/09

Benton County Surveyor's Office  
 Chris Hoglund, Deputy County Surveyor  
 Minnesota License No. 43932

**Statement of Evidence:****M013**

East Quarter Corner of Section 1, Township 36 North, Range 31 West, Sauk Rapids Township, 4<sup>th</sup> Principal Meridian, Benton County, Minnesota.

- 1849 Original US General land Office survey set a wood post at the edge of a brook for the corner one reference tie was noted:  
           4' Diameter Rock           N 49 1/2 W           157 links
- 1876 County Surveyor's Record Book 1, page, 233, shows a road survey by R. Cronk along the east line of Section 1 with a distance of 83.50 chains (5511.0 feet).
- 1917 County Records contain a survey subdividing Section 6, 36-30 by R.H. West, which notes a stake at this corner. The survey gives a distance of 2889 feet to the NW corner Sec 6 and a distance of 2654 feet to the SW corner Sec 6. (Which appears to be at the lost position.)
- 1938 County Engineers' Notebook No. 116 shows survey of SAR 1 running from south to north. Notes show corner being a nail in center of road and fence east. Ties:  
           FP     E     29.5'  
           FP     NE    46.95'  
 Stationing gives distances of 2653.1 feet to the SE corner and 2930.0 feet to the NE corner with a delta angle of 0-25' left.
- Undated County Highway ties:  
           FP     NE     34.4  
           FP     SE     39.4
- 1977 County Surveyor's Record Book 1, page 239, notes the following ties:  
           FP                    NW     41.46  
           FP                    W     35.23  
           FP                    SW     36.37  
           Top N end Culvert       NE     50.61  
           Top S end Culvert       SE     54.90  
           PP                    NE     49.55
- 1990 Paul E. Wellen, LS 10461, set a cast iron monument in the centerline of a north/south road and in line with tree line east and filed a Certificate of Location (#201468). His notes show distances of 2927.04 feet to the NE corner and 2652.57 feet to the SE corner. Tie to PP NE 49.17'.
- 2004 Found CIM and measured 2652.49 feet to the SE corner and 2927.26 feet to the NE corner. Searched for rock referred to in GLO notes, but area has been graded for road ditch and found no evidence. Corner is 20.44 feet south of the lost position and 5.06 feet east of a straight line between section corners.  
 County Coordinates obtained by GPS to CIM:  
 NAD 83 (1996 Adjustment)  
 N- 129221.039  
 E- 478561.205
- 2008 Westwood Professional Services, Inc. found a cast iron monument in the centerline of CR 1 and in line with a tree line to the east. CIM fit substantially well to the two culvert ties and the tie to the PP NE as noted in the County Surveyor's Record book dated 1977. Measured 2927.26 feet to the NE corner and 2652.49 feet to the SE corner of Section 1 which agrees with Wellen distances. CIM is accepted as marking the obliterated position for this corner. Coordinates obtained by GPS coincide with 2004 position.


# CERTIFICATE OF LOCATION OF GOVERNMENT CORNER

EAST 1/4 Corner of Section 1, Township 36, Range 31, 4th P.M.  
STATE OF MINNESOTA, County of BENTON

At the corner location shown on the sketch:

- On \_\_\_\_\_ found a \_\_\_\_\_  
DATE
- left monument as found,  lowered monument,  removed monument (explain)
- On 2 AUG. 1990 placed a COUNTY MONUMENT  
DATE

## SKETCH OF REFERENCE TIES

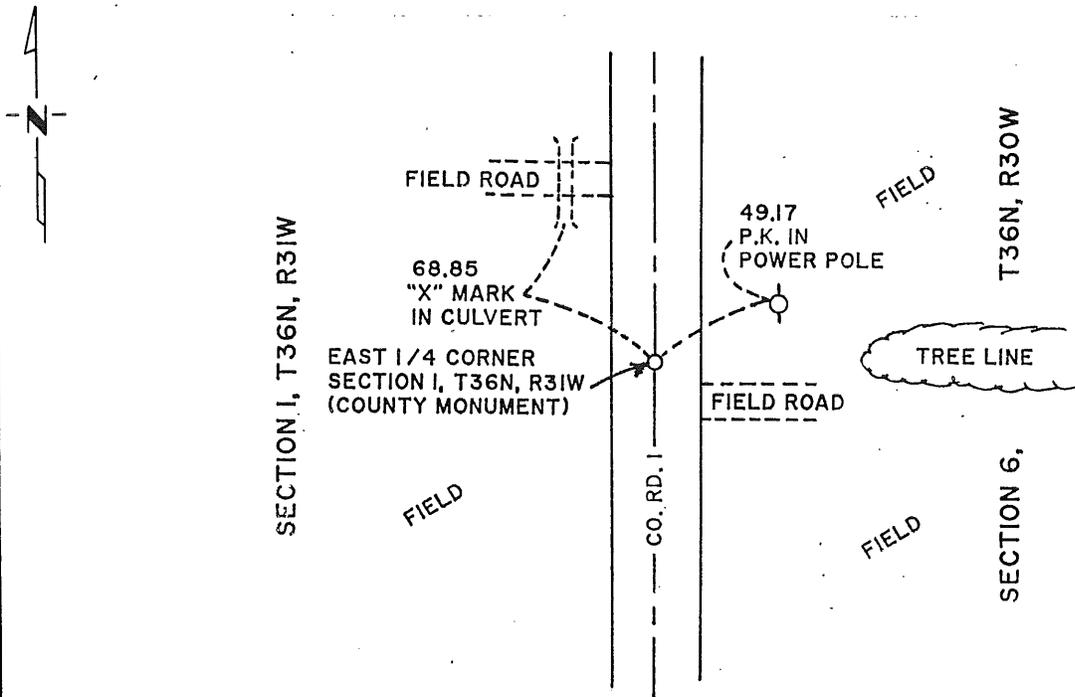

Statement of evidence relative to this corner location is on back of page.

I hereby certify that this document and the data contained herein was prepared by me or under my direct supervision.

[Signature] 2 AUG. 1990  
SIGNATURE DATE

Registration No. 10461

- Land Surveyor,  Professional Engineer
- County Surveyor,  County Engineer

### OFFICE OF THE COUNTY RECORDER

County of \_\_\_\_\_

I hereby certify that this document was filed in the Co. Recorders office at \_\_\_\_\_ .M. on the \_\_\_\_\_ day of \_\_\_\_\_ A.D., 19 \_\_\_\_\_

County Recorder \_\_\_\_\_

By \_\_\_\_\_, Deputy

DOCUMENT NO. \_\_\_\_\_

Statement of Evidence:

East 1/4 corner, of Section 1, T 36  
N, R 31 W, of the 4th Principal Meridian.

1. During the G.L.O. Survey of 1850, Mr. John Ryan, a U.S. Deputy Surveyor, set a wood post to mark this corner.
2. A search of the Benton County Surveyor records indicate ties to a corner (type not indicated) in 1977.
3. On August 2, 1990, Paul E. Wellen & Associates, Inc., set a cast iron monument at this location and established new reference ties as indicated.

201468

OFFICE OF  
BENTON COUNTY RECORDER  
BENTON COUNTY, MN  
CERTIFIED TO BE FILED  
AND/OR RECORDED ON

FEB 25 8 19 AM '91

ALICE G. ENGELMEYER  
COUNTY RECORDER

BY Jan DEPUTY