

A 362422

Certified, Filed and or Recorded on  
Dec. 16, 2008 AT 02:00PM


Signed: BW  
MARILYN J NOVAK G V  
BENTON COUNTY MINNESOTA  
MARILYN J NOVAK  
COUNTY RECORDER

# CERTIFICATE OF LOCATION OF GOVERNMENT CORNER

EAST QUARTER Corner of Section 9, Township 36N, Range 31W  
4TH Principal Meridian, State of Minnesota, County of Benton

At the corner location shown on the sketch:

- On 11/26/08 found a 1/2" OPEN IRON PIPE FLUSH WITH ROAD SURFACE
- left monument as found       lowered monument       removed monument (explain)
- On \_\_\_\_\_ placed an \_\_\_\_\_

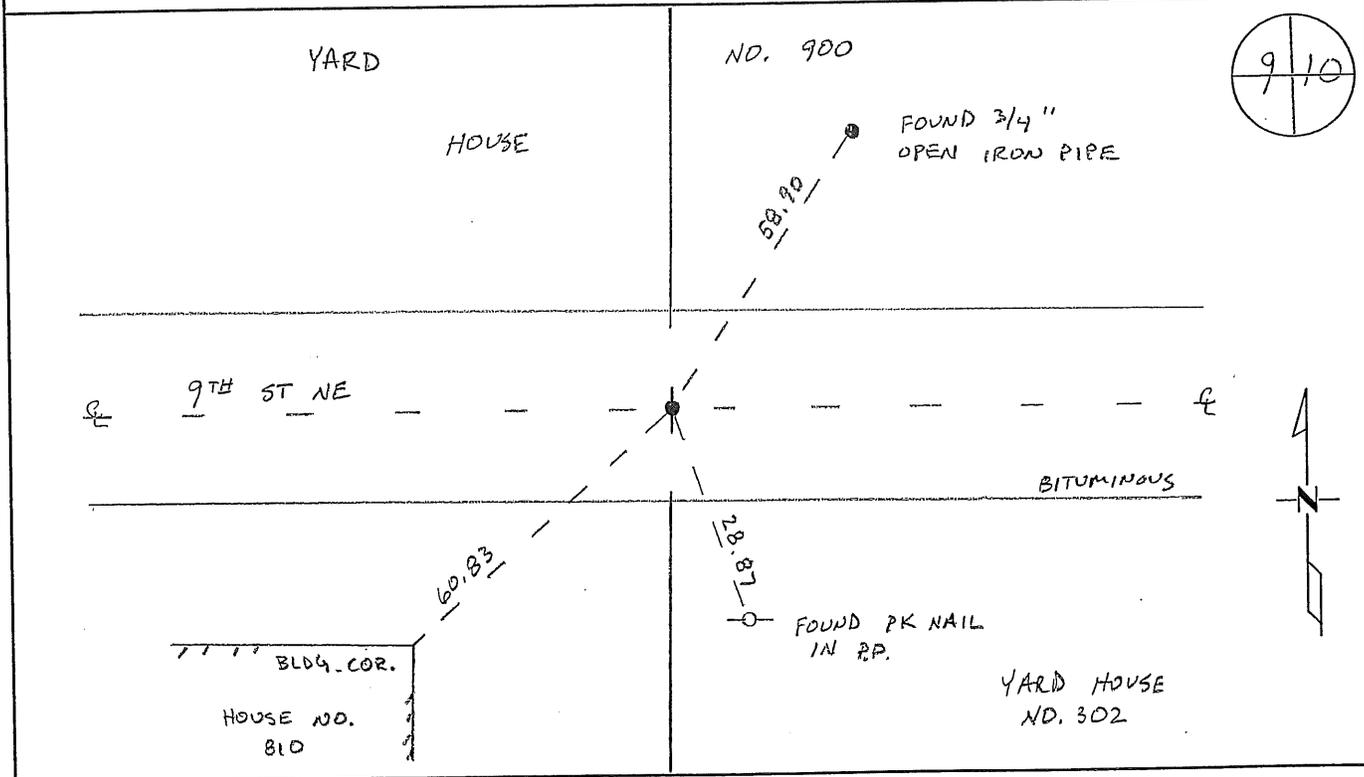

Statement of evidence for this corner location is on back of this page.

I hereby certify that this document was researched and prepared by me or under my direct supervision and that I am a licensed Land Surveyor under the laws of the State of Minnesota.

Signature M. L. ...  
Deputy Benton County Surveyor  
License No. 46170

Date: 12/12/08

Benton County Surveyor's Office  
 Nancy H. Lewis, Deputy County Surveyor  
 Minnesota License No. 46170

**Statement of Evidence:****M093**

East Quarter Corner of Section 9, Township 36 North, Range 31 West, Sauk Rapids Township, 4<sup>th</sup> Principal Meridian, Benton County, Minnesota.

1850 Original US General Land Office survey set a wood post for this location and bearing trees were recorded.

6" Blk Oak	N 77 E	157 links
4" Blk Oak	N 48 W	116 links

This corner is noted on the following recorded plats:

<i>BRENDA LEE ADDITION (CIM)</i>	5/29/1992	Vernon H. Bartz
<i>FRITZ ADDITION (CIM)</i>	5/7/1987	Sidney Williamson
<i>GUZMAN SARTELL ADDITION</i>	6/21/1982	Sidney Williamson

1987 Sidney P. Williamson, LS 10918, set a cast iron monument at the corner location. This corner was identified in the 1905 Plat of the Townsite of Sartell. This plat has been perpetuated since that time and provides conclusive evidence for the restoration of this obliterated corner. A Certificate of Location (#181081) was filed.

2002 No resurvey information was found on this corner in the Benton County records.

2003 Westwood Professional Services, Inc. found a ½ " iron pipe at the corner. Corner now falls in east-west street and CIM set in 1987 has been destroyed. Distances north and south to section corners and angle at this corner checked well with Paul Wellen, LS 10461, information in 1989.

County Coordinates Obtained by GPS:

NAD 83 (1996 Adjustment)

N- 123832.000

E- 462581.771

2008 The County Surveyor's Office searched and found a ½ inch open iron pipe at the centerline of an east-west road (9<sup>th</sup> Street N.E.). Tie distances to a NE ¾" iron pipe, a SE power pole, and the NE corner of a SW house check well with Williamson's 1987 record. The position gives distances to the NE Cor. and SE Cor. of 2749.61 feet and 2640.01 feet respectively. Surveyor accepts iron pipe position and updated ties. Coordinates obtained by GPS agree with those reported by Westwood in 2003.

# CERTIFICATE OF LOCATION OF GOVERNMENT CORNER

EAST QUARTER Corner of Section 9, Township 36, Range 31, 4th P.M.

STATE OF MINNESOTA, County of BENTON


At the corner location shown on the sketch:

On \_\_\_\_\_ found a \_\_\_\_\_  
DATE

left monument as found,  lowered monument,  removed monument (explain)

On JAN. 5, 1987 placed a CAST IRON MONUMENT  
DATE

### SKETCH OF REFERENCE TIES

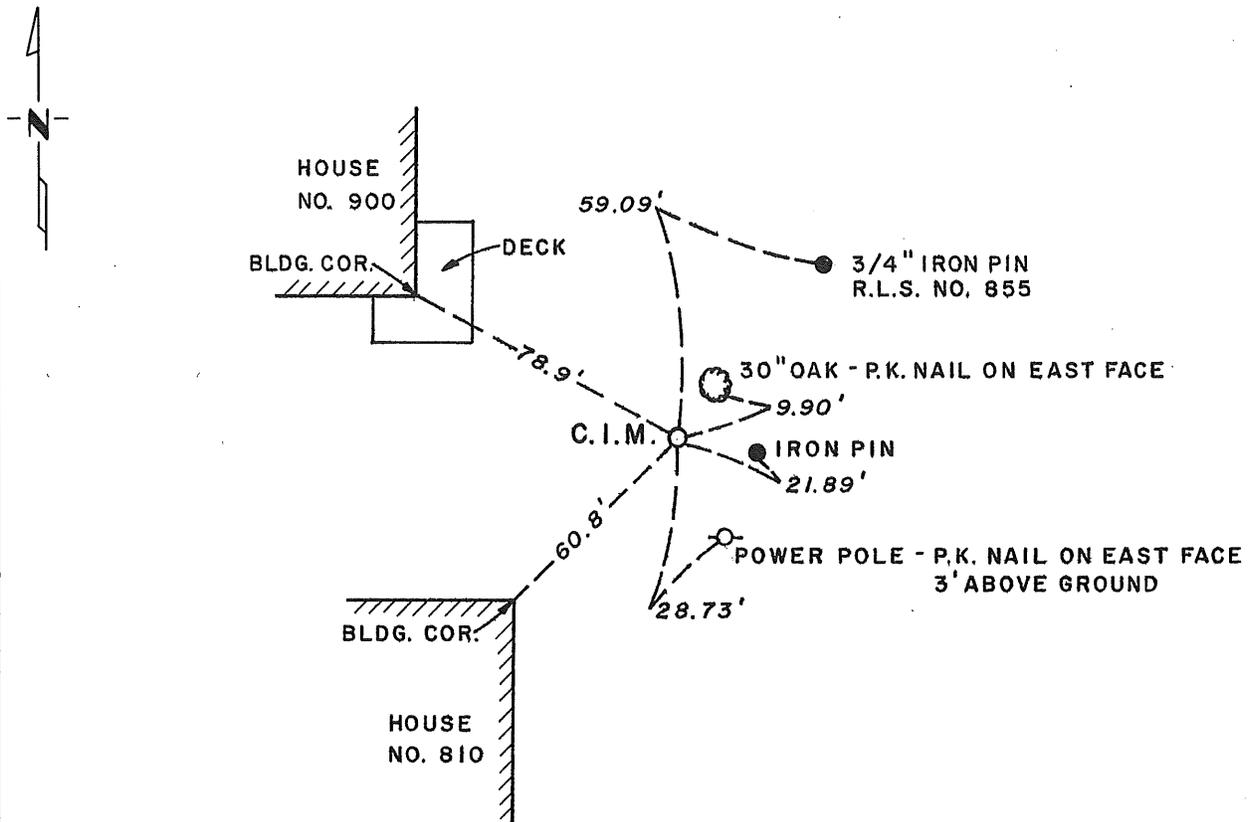

Statement of evidence relative to this corner location is on back of page.

I hereby certify that this document and the data contained herein was prepared by me or under my direct supervision.

Sidney P. Williamson 1/8/87  
SIGNATURE DATE

Registration No. 10918

- Land Surveyor,  Professional Engineer  
 County Surveyor,  County Engineer

County Recorder  
~~REGISTER OF DEEDS~~  
OFFICE OF THE REGISTER OF DEEDS  
County of Benton

I hereby certify that this document was filed in the Reg. of Deeds office at 9 A.M. on the 16 day of January A.D., 19 87

Register of Deeds Alice C. Engelmeier  
County Recorder

By Jw., Deputy

DOCUMENT NO. 181081

**Statement of Evidence:**

1. Post was set, at the E $\frac{1}{4}$  Corner of Section 9, by the U.S. Government Surveyors. The Township was surveyed from Oct. 5, 1849 to Nov. 1, 1850.
2. Subject corner (E $\frac{1}{4}$  Corner of Section 9) was identified in the 1905 Plat of the Townsite of Sartell. This plat has been perpetuated since that time and provides conclusive evidence for the restoration of this obliterated corner.