

A 372448

Certified, Filed and or Recorded on
Feb. 24, 2010 AT 01:06PM


Signed: CK
MARILYN J NOVAK G V I
BENTON COUNTY MINNESOTA
MARILYN J NOVAK
COUNTY RECORDER

CERTIFICATE OF LOCATION OF GOVERNMENT CORNER


North Quarter Corner of Section 5, Township 36 North, Range 29 West, Fourth Principal Meridian, Benton County, Minnesota.

At this corner location shown on the sketch:

- On 2/19/2010 found a CAST IRON MONUMENT
- left monument as found lowered monument removed monument (explain)
- On _____ placed an _____

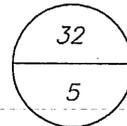

55TH STREET NE

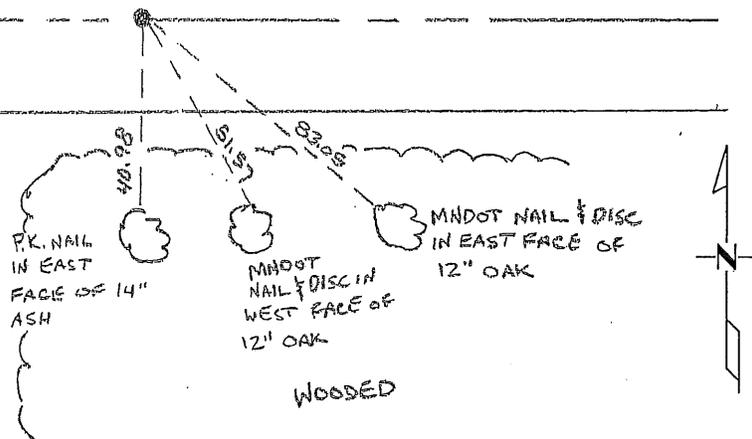

Statement of evidence for this corner location is on back of this page.

I hereby certify that this document was researched and prepared by me or under my direct supervision and that I am a Licensed Land Surveyor under the laws of the State of Minnesota.

Signature *John H. Cah*
Deputy Benton County Surveyor
License No. 45873

Date: 2/22/2010

Benton County Surveyor's Office
 Nathan H. Carlson, Deputy County Surveyor
 Minnesota License No. 45873

Statement of Evidence:**K051**

North Quarter Corner of Section 5, Township 36 North, Range 29 West, St. George Township, 4th Principal Meridian, Benton County, Minnesota.

1849 Original US General Land Office survey established this corner set a wood post at this location and bearing trees were recorded.

10" Blk Oak	N 5 W	17 links
8" Blk Oak	S 33 W	22 links

1913 County Surveyor Record Book, pages 30 and 32, contains a survey in Section 5 by J. A. Stanton. Survey shows corner being preserved by Mr. Galmault from original survey.

Undated County Surveyor's Record Book 1, page 523, notes a distance of 2671.0 feet to the NE corner of Section 5 with an Iron Monument set at the 1/16th corner between and the following reference ties to a stake at the corner:

Culvert N-end	East	44.15
Culvert S-end	East	43.25

1992 Paul Wellen, LS 10461, set a cast iron monument at the centerline of roads east/west and a field line north. He filed a Certificate of Location (#216293).

2004 MN/DOT found CIM. Measured 2660.40 feet to the NW corner and 2672.11 feet to the NE corner.

County Coordinates obtained by GPS
 NAD 83 (1996 Adjustment)
 N- 132207.901
 E- 518461.786

2010 Westwood Professional Services, Inc. found a CIM in the east-west centerline with the distance to the east comparing within about a foot of the 1913 distance. Believing the CIM to be the best available evidence of the obliterated position, reference ties were updated and the 2004 MnDOT coordinates were verified.

CERTIFICATE OF LOCATION OF GOVERNMENT CORNER


North Quarter Corner of Section 5, Township 36, Range 29, 4th P.M.

STATE OF MINNESOTA, County of Benton

At the corner location shown on the sketch:

- On _____ found a _____
DATE
- left monument as found, lowered monument, removed monument (explain)
- On 8-18-92 placed a Cast Iron Monument (Down 0.3')
DATE

SKETCH OF REFERENCE TIES

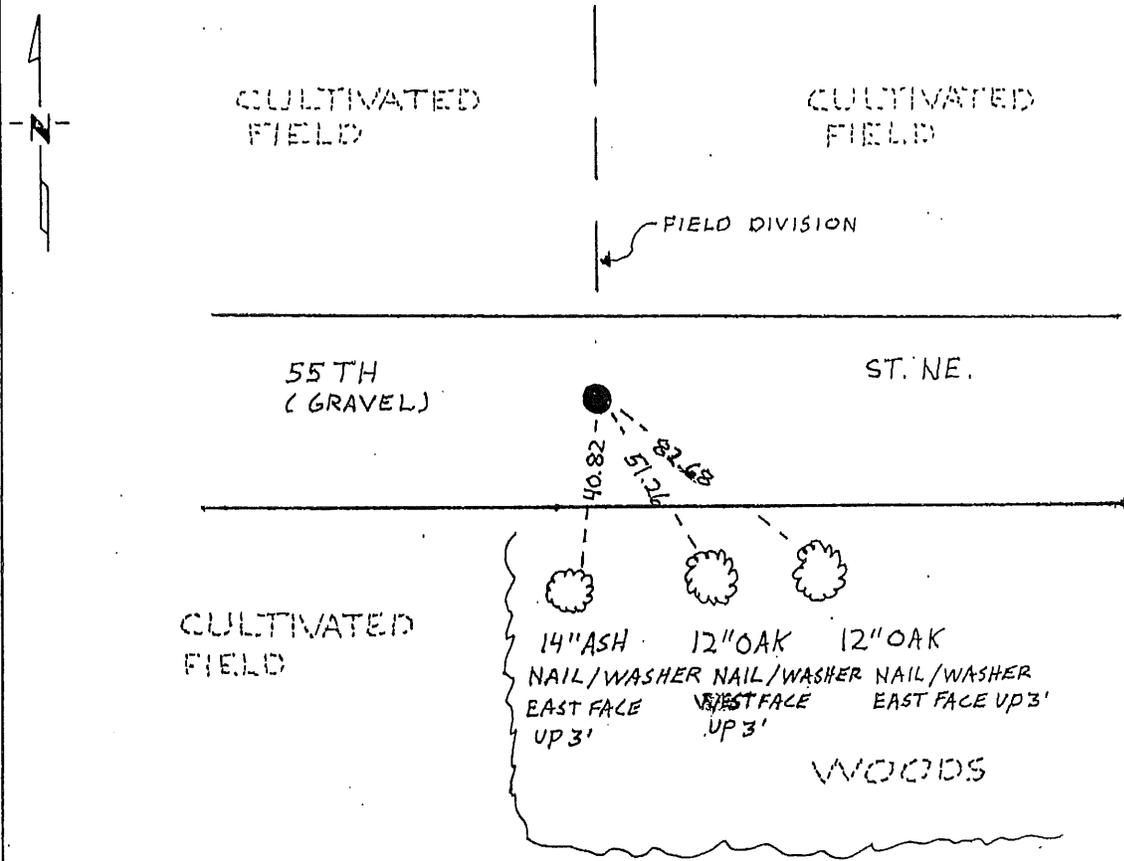

Statement of evidence relative to this corner location is on back of page.

I hereby certify that this document and the data contained herein was prepared by me or under my direct supervision.

[Signature] 2/12/93
 SIGNATURE DATE

Registration No. 10461

- Land Surveyor, Professional Engineer
- County Surveyor, County Engineer

OFFICE OF THE COUNTY RECORDER

County of _____

I hereby certify that this document was filed in the Co. Recorders office at _____ .M. on the _____ day of _____ A.D., 19 _____

County Recorder _____

By _____, Deputy

DOCUMENT NO. _____

Statement of Evidence:

NORTH QUARTER CORNER, SECTION 5, T 36N, R 29W 4TH P.M.

1. During the G.L.O. survey of 1849, Mr. Theodore Conkey, a U.S. Deputy Surveyor, set a wood post to mark said corner.
2. Benton County's old surveyor's books provide no information to locate said corner.
3. On August 18, 1992, Paul E. Wellen & Associates searched for said corner. We located a Field Division line to the north 55th Street NE. We accepted this Field Division line as evidence of said corner. On August 18, 1992, we set a Cast Iron Monument at said Field line and established new reference ties as indicated.

216293

OFFICE OF
BENTON COUNTY RECORDER
BENTON COUNTY, MN
CERTIFIED TO BE FILED
AND/OR RECORDED ON

JUL 14 1 23 PM '93

ALICE G. EMMERMEYER
COUNTY RECORDER

BY  DEPUTY