

Certified, Filed and or Recorded on
Dec. 16, 2008 AT 01:44PM


Signed: BW
MARILYN J NOVAK 6 V
BENTON COUNTY MINNESOTA
MARILYN J NOVAK
COUNTY RECORDER

CERTIFICATE OF LOCATION OF GOVERNMENT CORNER

NORTHEAST Corner of Section 16, Township 36N, Range 29W
4TH Principal Meridian, State of Minnesota, County of Benton

At the corner location shown on the sketch:

- On 10/13/08 found a CAST IRON MONUMENT
- left monument as found lowered monument removed monument (explain)
- On _____ placed an _____

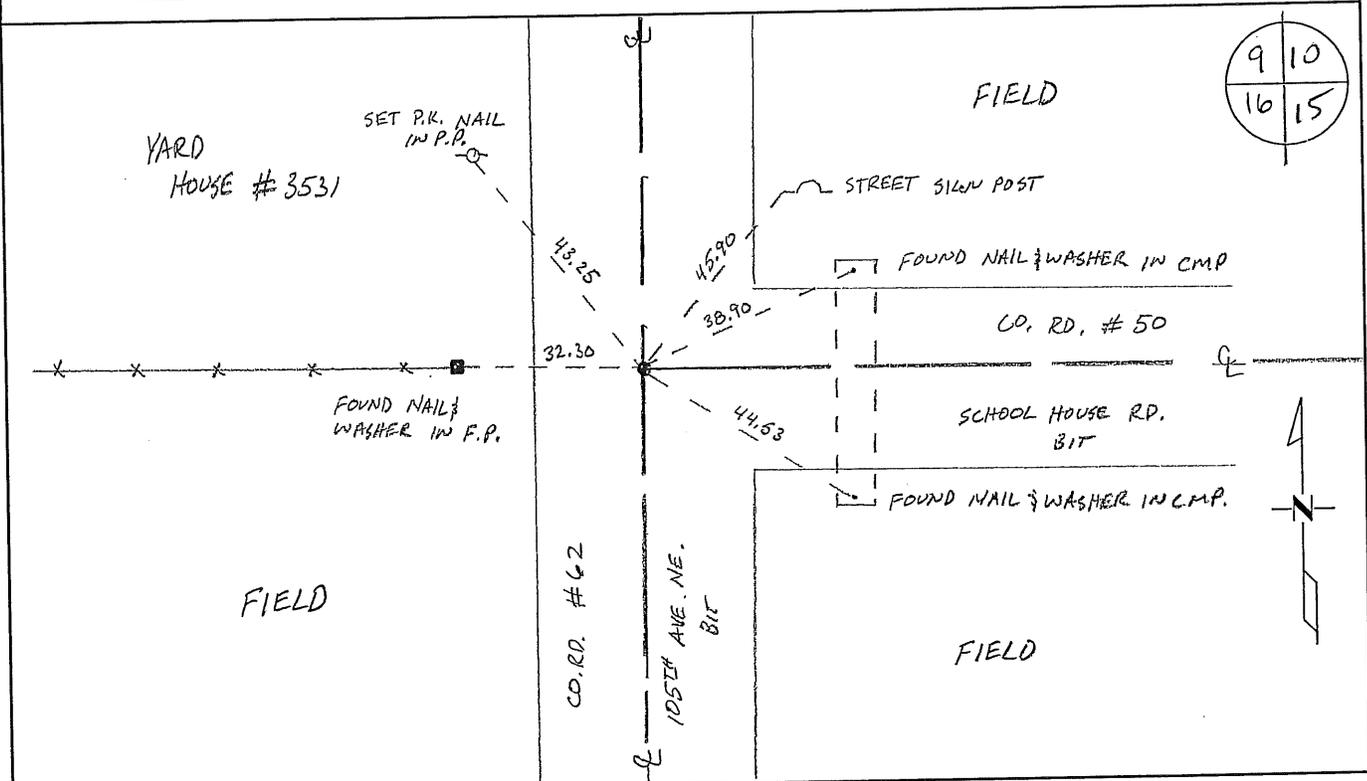

Statement of evidence for this corner location is on back of this page.

I hereby certify that this document was researched and prepared by me or under my direct supervision and that I am a licensed Land Surveyor under the laws of the State of Minnesota.

Signature [Handwritten Signature]
Deputy Benton County Surveyor
License No. 45872

Date: 11/06/2008

PAGE 1 OF 2

Benton County Surveyor's Office
 Jason W. Oberg, Deputy County Surveyor
 Minnesota License No. 45872

K162

Statement of Evidence:

Northeast Corner of Section 16, Township 36 North, Range 29 West, St. George Township, 4th Principal Meridian, Benton County, Minnesota.

1855 Original US General Land Office survey established corner marked by a wood post with bearing trees:

10" Aspen	S 15 E	148 links
5" Aspen	N 13 W	43 links

1931 County Engineer's Notebook No. 61 contains road survey that shows corner marked by hub and iron with ties:

T.P.	SE	38.6'
Cor. F. P.	NE	38.3'

Notes show road east and fence line west. Notation in 1957 shows corner found.

1933 County Engineer's Notebook No. 67 shows road survey by H. G. Elletson running east-west. Corner is shown as an iron and hub at PI with road north-south with ties:

T.P.	SE	38.6'
Cor. FPNE		38.3'

1962 County Surveyor's Record Book 1, page 115, notes a hub and an iron with the following reference ties:

Sign Pst	NE	46.0
PP	NW	45.3
TP	SE	58.0

1974 County Surveyor's Record Book 1, page 101, notes a hub and an iron monument with the following reference ties:

Cor FP	W	32.4
PP	NW	45.3

1986 Benton County Highway records note a large nail was set on the centerlines of County Road 62 and County Road 50.

1992 Paul Wellen, LS 10461, found a nail and replaced it with a cast iron monument and filed a Certificate of Location (#216289).

2008 The County Surveyor's Office searched and found a cast iron monument at the intersection of the centerline of north-south 105th Ave. N.E. (County Road No. 62) and east School House Road (County Road No. 50) and is on line with a fence line to the west. Position agrees with 1962 ties to power pole and sign. The Surveyor accepts the CIM position and ties were updated.

Coordinates Obtained by GPS to CIM
 NAD 83 (1996 Adjustment)
 N- 121757.510
 E- 526868.950

CERTIFICATE OF LOCATION OF GOVERNMENT CORNER

Northeast Corner of Section 16, Township 36, Range 29, 4th P.M.

STATE OF MINNESOTA, County of Benton


At the corner location shown on the sketch:

On 8-18-92 found a Nail
DATE

left monument as found, lowered monument, removed monument (explain)

On 8-18-92 placed a Cast Iron Monument (Flush)
DATE

SKETCH OF REFERENCE TIES

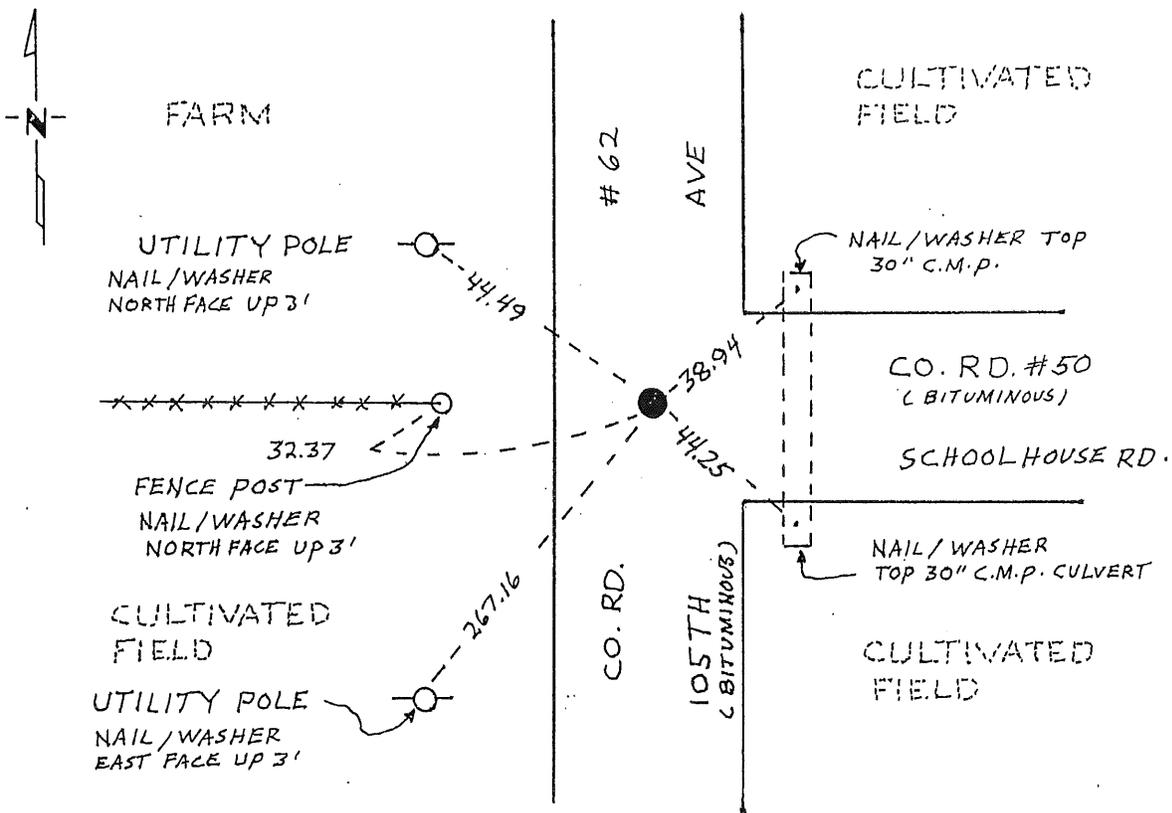

Statement of evidence relative to this corner location is on back of page.

I hereby certify that this document and the data contained herein was prepared by me or under my direct supervision.

[Signature] 2-16-93
SIGNATURE DATE

Registration No. 10461

Land Surveyor, Professional Engineer

County Surveyor, County Engineer

OFFICE OF THE COUNTY RECORDER

County of _____

I hereby certify that this document was filed in the Co. Recorders office at _____ .M. on the _____ day of _____ A.D., 19 _____

County Recorder _____

By _____, Deputy

DOCUMENT NO. _____

Statement of Evidence:

NORTHEAST CORNER, SECTION 16, T 36N, R 29W, 4TH P.M.

1. During the G.L.O. survey of 1855, Oscar F. Davis, a U.S. Deputy Surveyor, set a wood post to mark said corner.
2. Benton County's old surveyor's books provided on 4/23/86, that a large nail set a center line of County Road #62 and center line County Road #50 to east.
3. On August 18, 1992, Paul E. Wellen & Associates searched for said corner. Found a nail at center line-center line of roads, we accepted center line-center line as evidence of location of said corner. On August 18, 1992, we set a Cast Iron Monument at center line-center line of County Road #62 and County Road #50. Also established new reference ties as indicated.

216289

OFFICE OF
BENTON COUNTY RECORDER
BENTON COUNTY, MO
CERTIFIED TO BE FILED
AND/OR RECORDED ON

JUL 14 1 23 PM '93

ALICE G. EISELMAYER
COUNTY RECORDER

BY *[Signature]* DEPUTY